


No part of a report of a marine casualty investigation shall be admissible as evidence in any civil or administrative proceeding, other than an administrative proceeding initiated by the United States. 46 U.S.C. §6308.

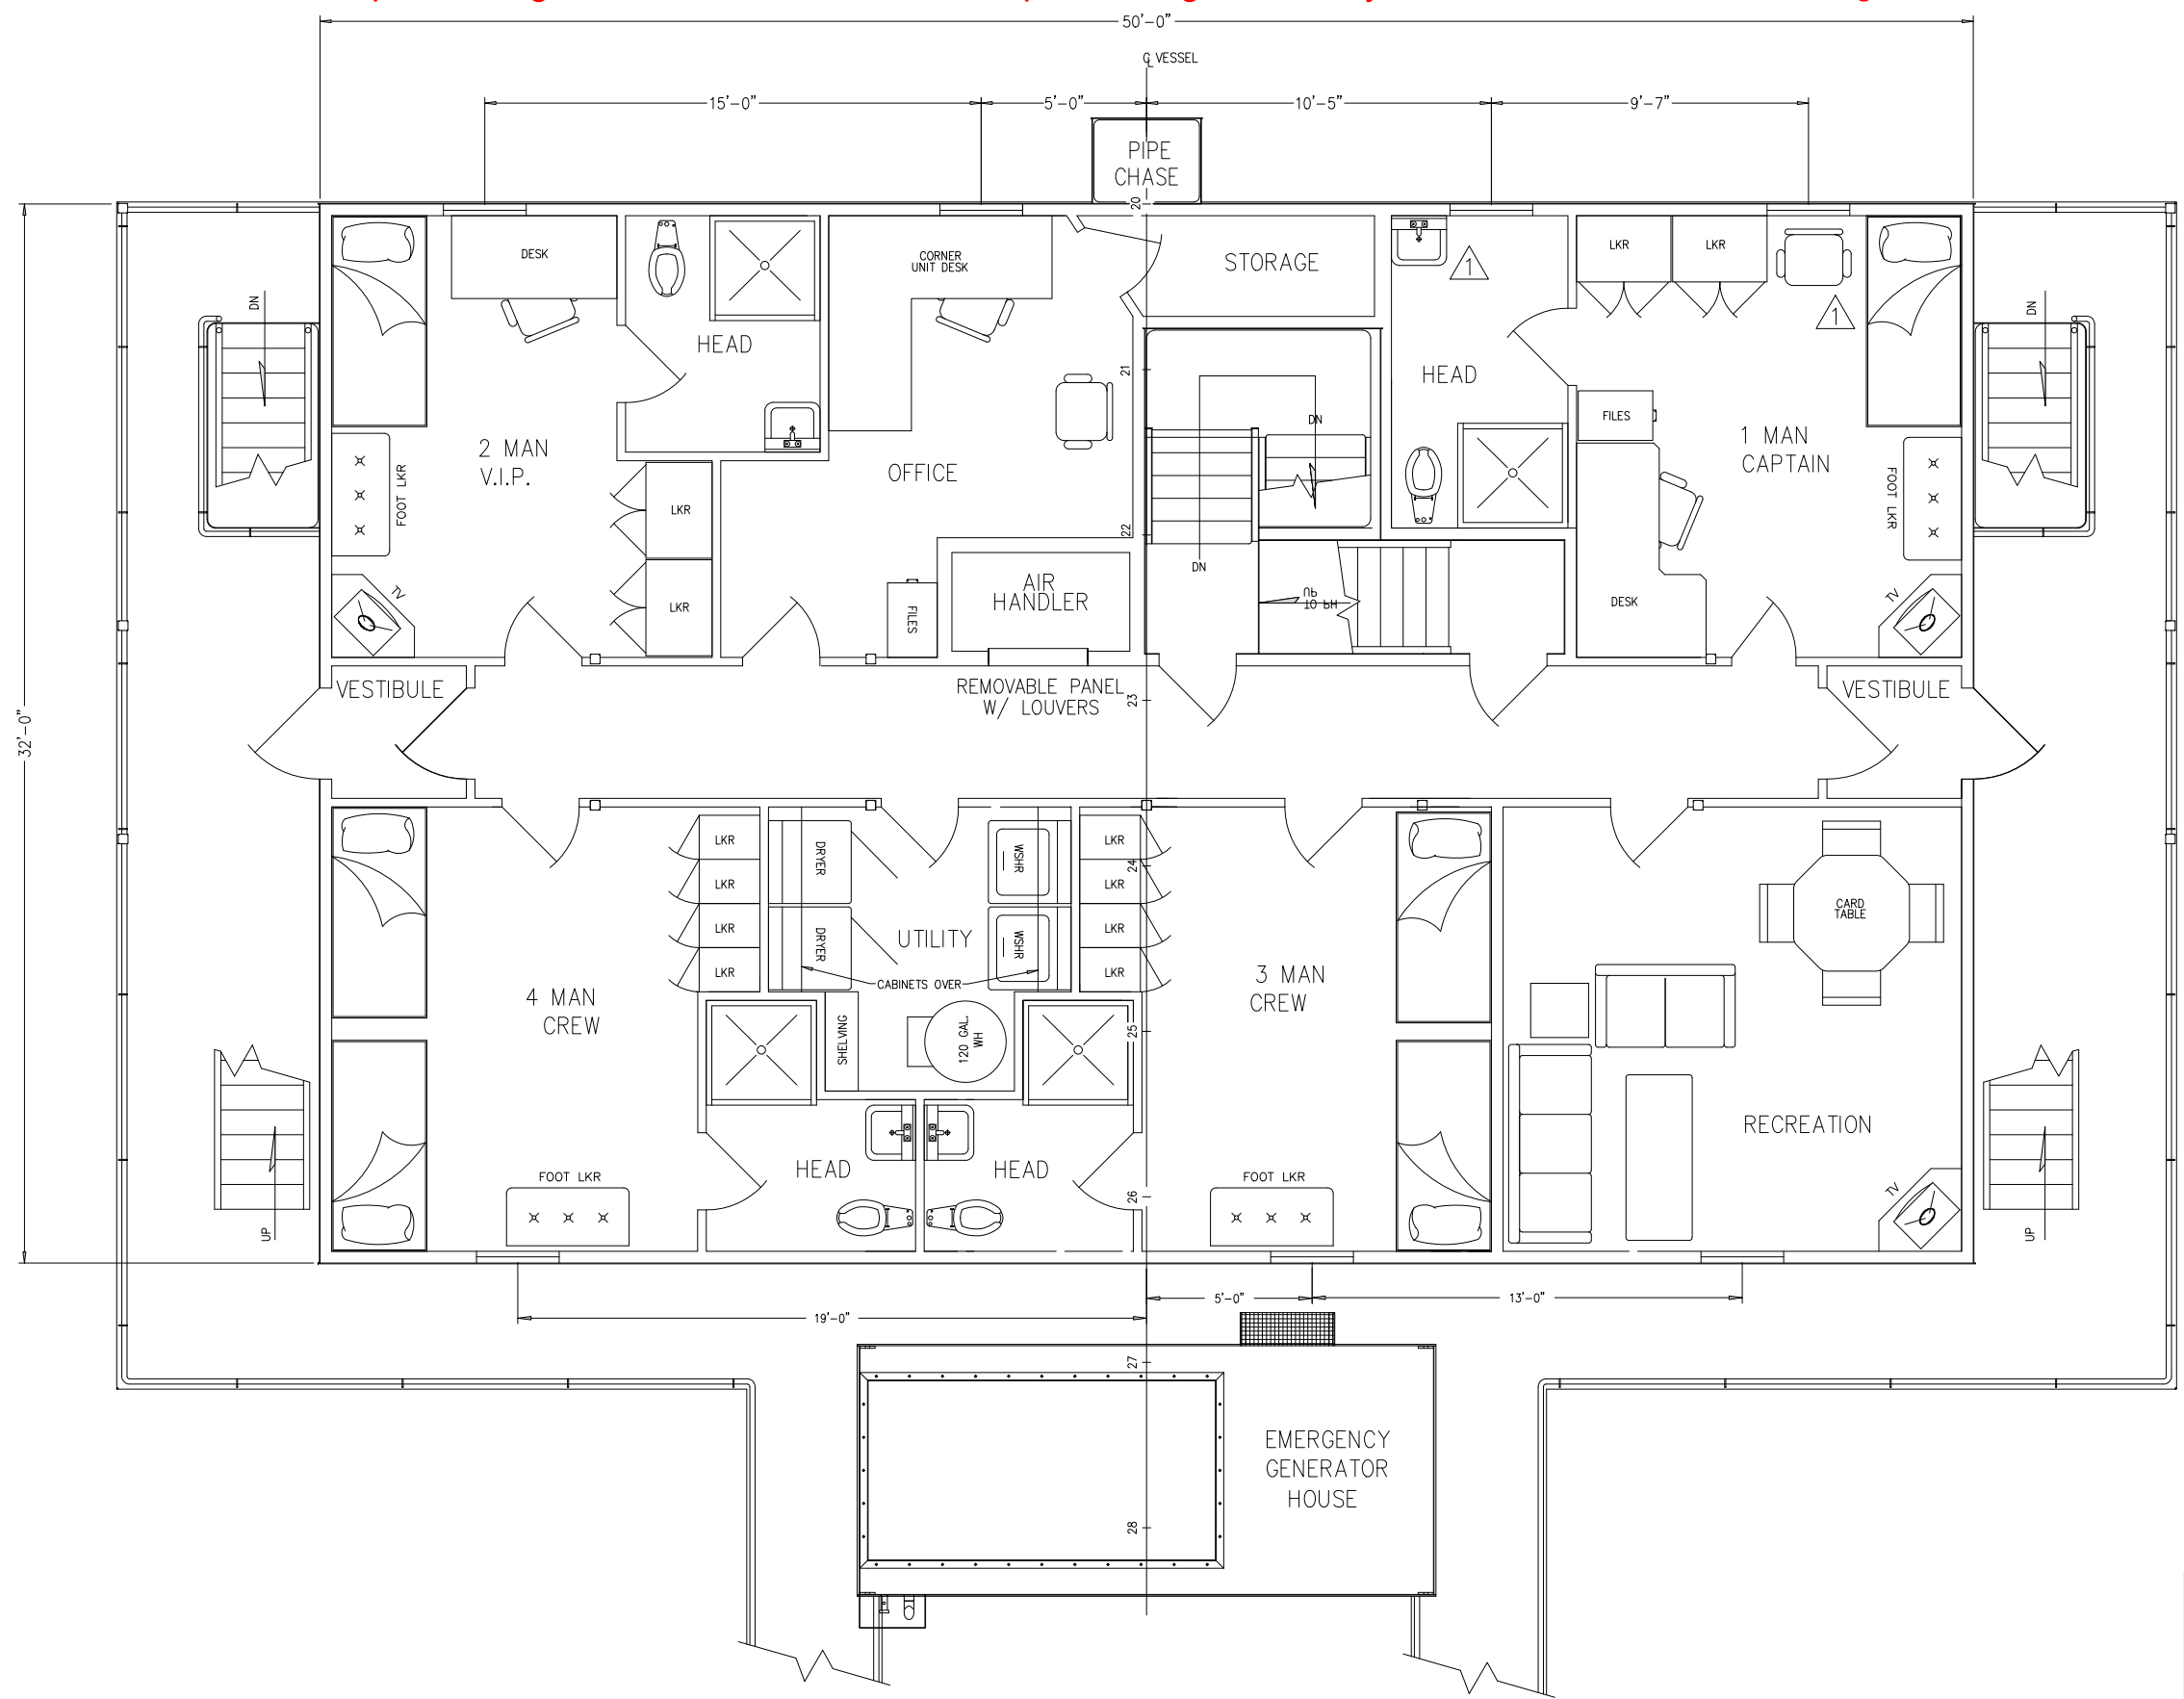

**03 LEVEL
LIVING QUARTERS**
9 PERSONS
SCALE: 3/8" = 1'-0"

REV	DESCRIPTION	DRAWN	DATE	APPROVED
0	ISSUED @ AFC STATUS	D.V.	09/11/00	G.L.
1	REVISED SINK LOC, DELETED DESK AND ADDED CHAIR	P.S.	09/13/01	G.L.
2	AS-BUILT	RJC	08/14/01	G.L.

REVISIONS

DRAWN SEMCO DATE 07/24/01
UPDATED DATE 07/24/01

SEMCO LLC		186 JEAN LAFITTE BLVD LAFITTE, LA 70067 PHONE: (504) 689-2054 FAX: (504) 689-2048 TOLL FREE: 1-800-736-2656	
MARINE ENGINEERING AND CONSTRUCTION			
VESSEL 166.5 FT x 103 FT x 13 FT LIFTBOAT "M/V DIXIE ENDEAVOR"			
TITLE LIVING QUARTERS DETAILED ARRANGEMENT			
SIZE D	HULL NO. 1009	DWG. NO. 1009-126	REV 2
SCALE 3/8" = 1'-0"		JOB NO. 1009	SHEET 4

THIS DOCUMENT AND INFORMATION AND DATA DISCLOSED HEREIN AND HEREWITH ARE THE CONFIDENTIAL AND PROPRIETARY PROPERTY OF SEMCO, LLC. AND ARE NOT TO BE USED, PRODUCED OR DISCLOSED IN WHOLE OR IN PART BY OR TO ANYONE WITHOUT THE WRITTEN PERMISSION OF SEMCO, LLC.

SEACOR POWER MBI Exhibit 96

D
C
B
A

D
C
B
A

8 7 6 5 4 3 2 1